
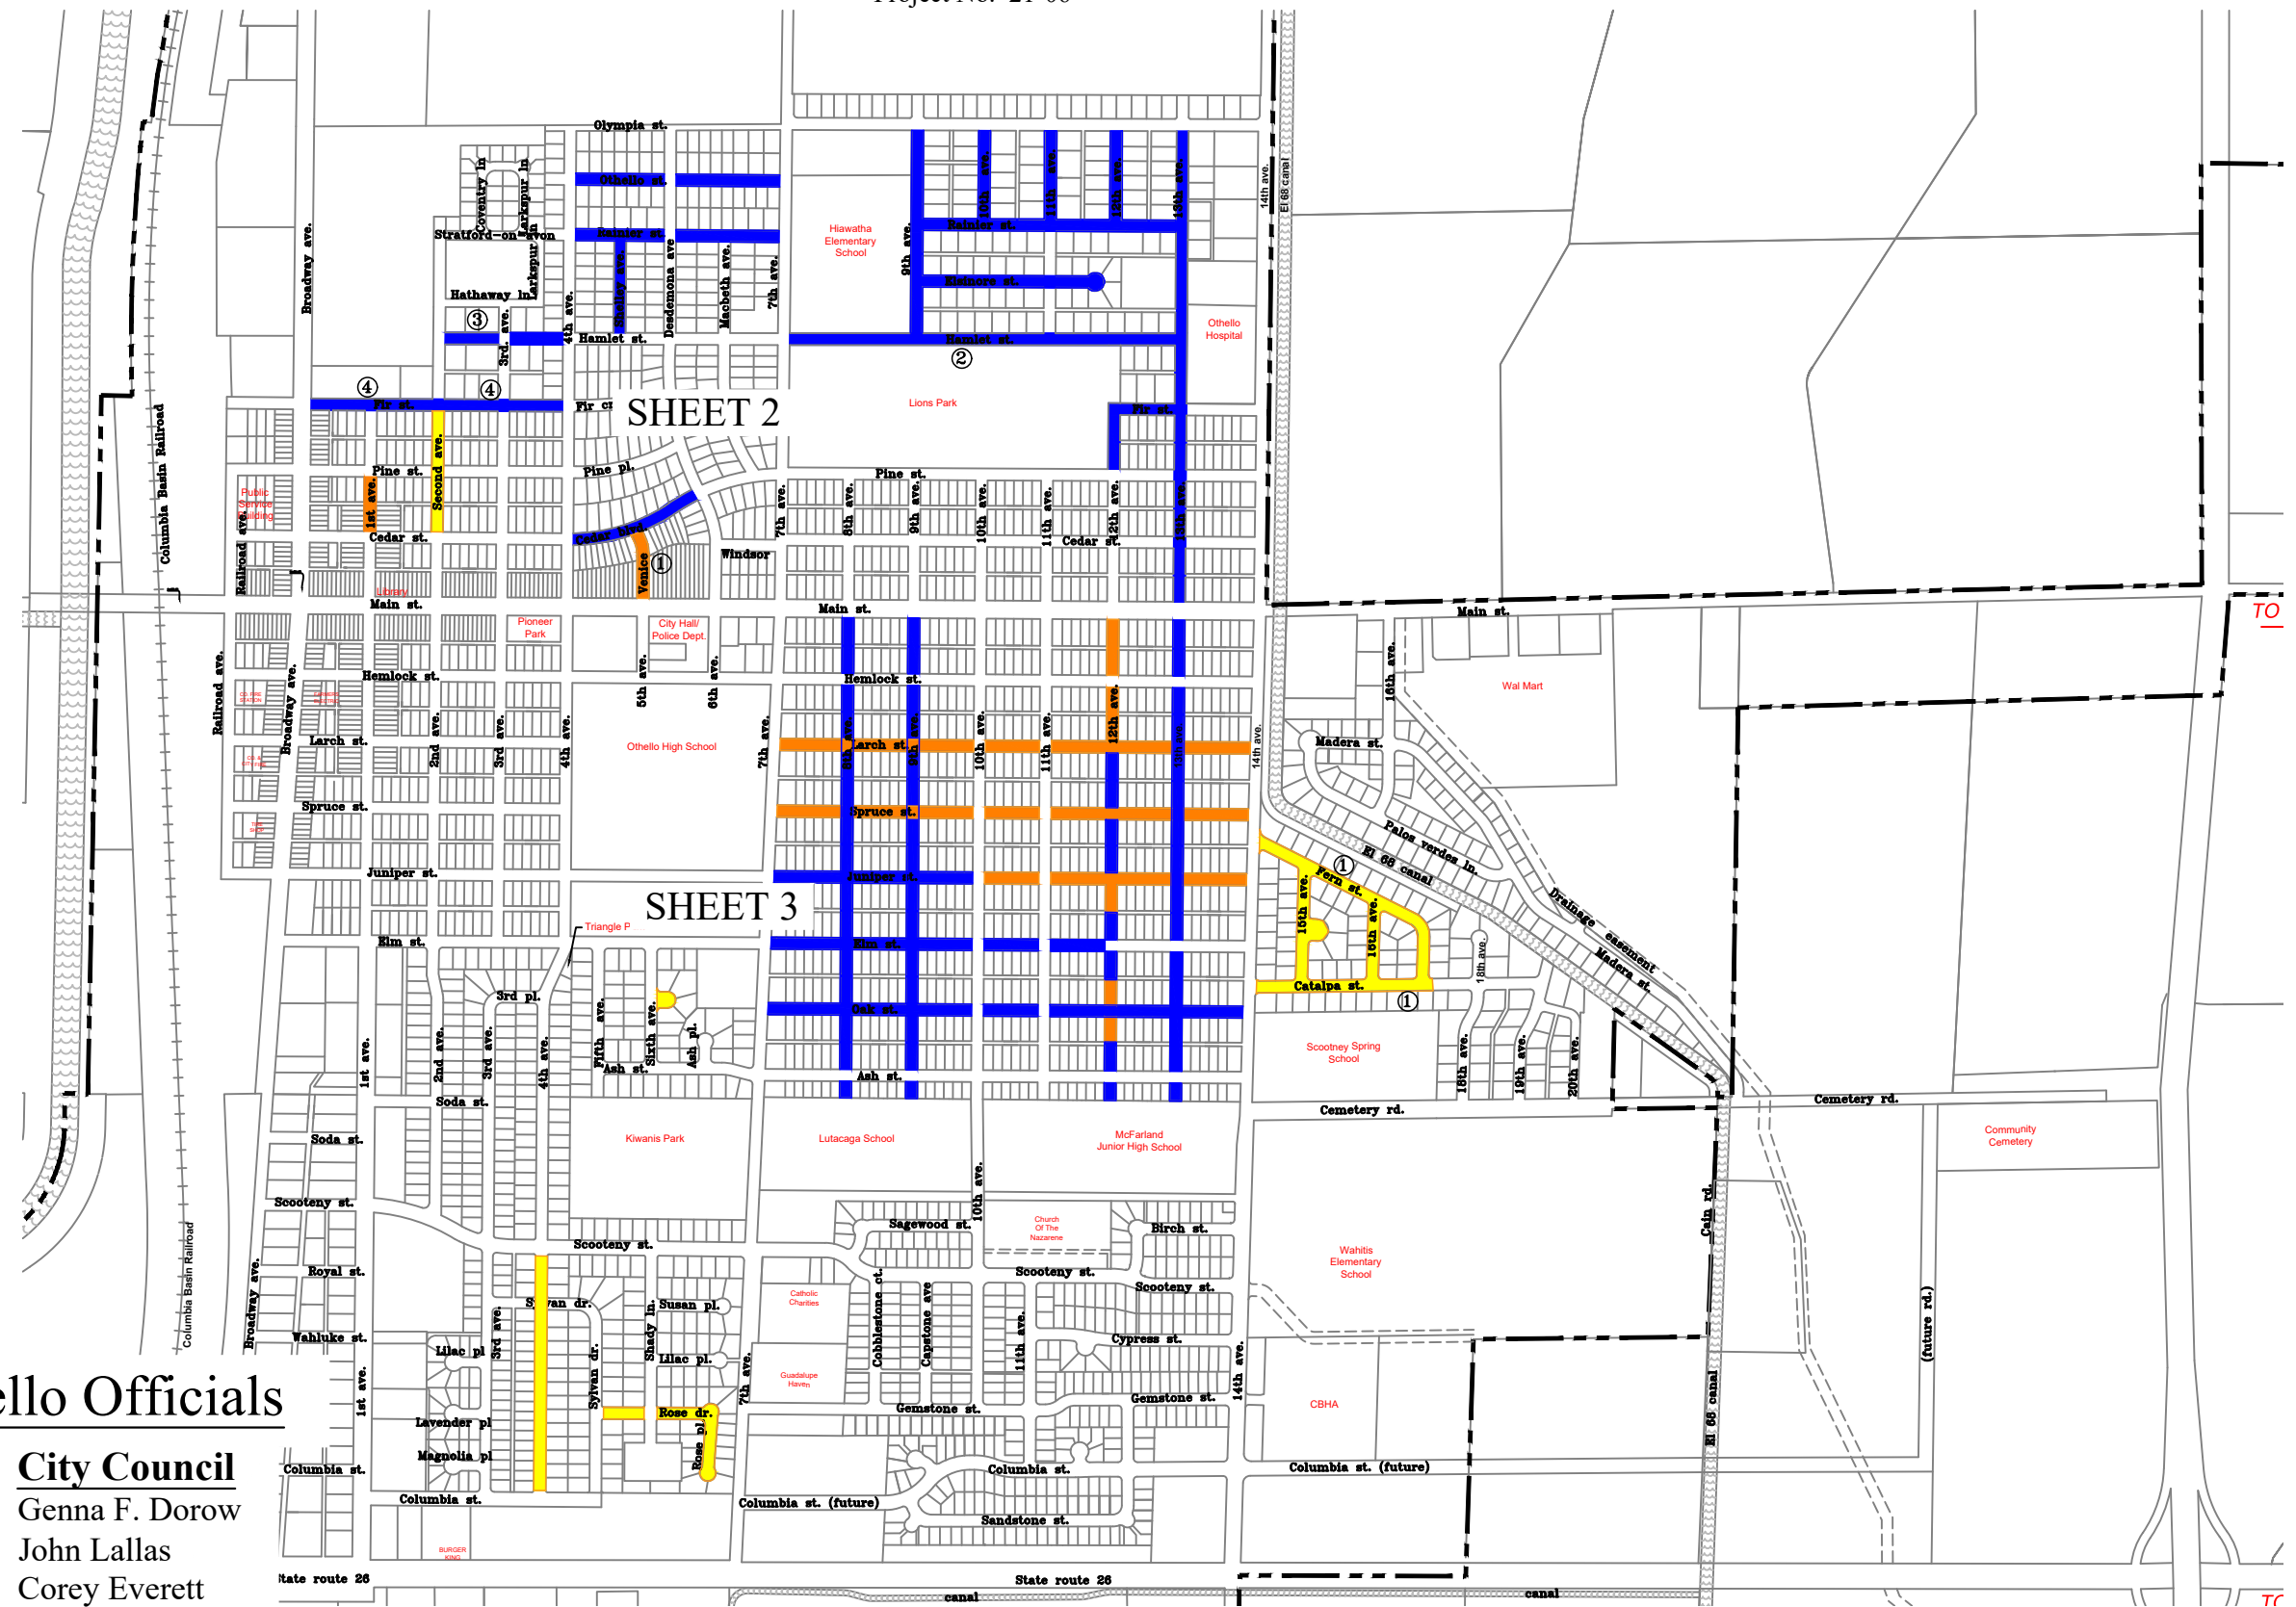


CITY OF OTHELLO, WASHINGTON

Chip Seal Project
Project No. 21-06

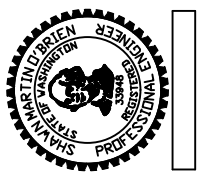

NO.	DATE	BY	REVISIONS
1			
2			
3			
4			
5			

CITY OF OTHELLO
ENGINEERING DEPARTMENT
500 East Main Street, Othello, WA 9934
Ph: 509-488-5686 ext. 126



SEAL COAT PROJECT - 2021
COVER SHEET

REVISION NO.	DESCRIPTION
1	CJC DRAWN BY SMO
2	Q.A. REVIEW
3	PLOT DATE NTS
4	PLOT SCALE 21-06
5	PROJ. NO.
6	REVISION NO.
7	Sheet 1

City Of Othello Officials

Mayor
Shawn Logan

City Council
Genna F. Dorow
John Lallas
Corey Everett
Jonathan Erikson
Maria Quezada
Mark T. Snyder
Angel Garza

City Engineer
Shawn O'Brien, P.E.

Public Works Director
Terry Clements

Project Vicinity Map

Drawing Sheets Included

- Sheet 1
- Sheet 2
- Sheet 3
- Cover Sheet
- Streets North of Main Street
- Streets South of Main Street